

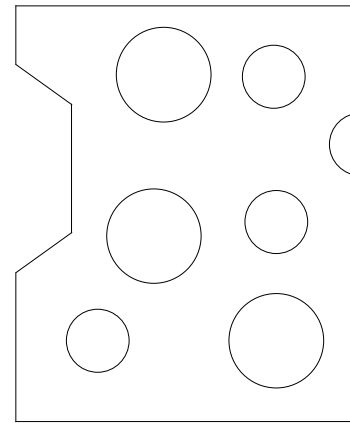
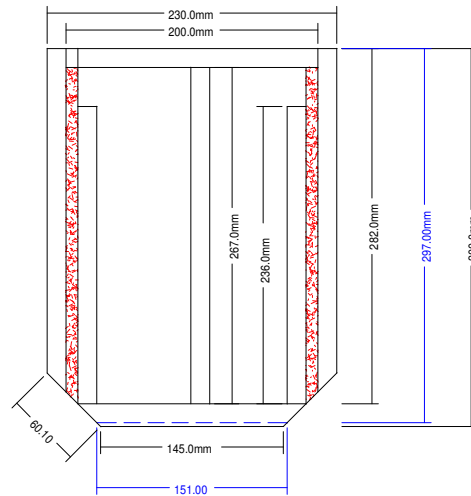


PLANET10 hifi  
 FOSTEX FE127E FONKEN  
 V1.0.3b  
 designed by D Dlugos  
 as built drawing by cjb

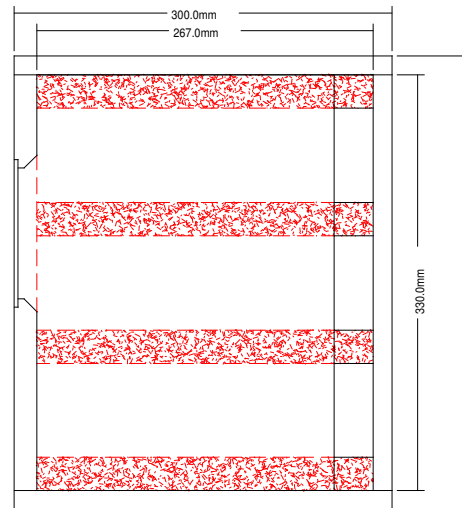

Clearance for input terminals  
 type / location optional

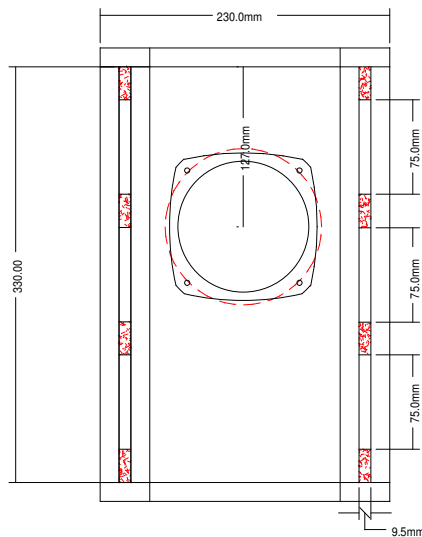

NOTES:

- 1) Drawn for Baltic birch plywood 15mm (not 5/8")  
 18mm (not 3/4") fronts.
- 2) Dimensions for optional use of 15mm  
 for front panel in blue.
- 3) 9.5mm (actual 3/8") MDF or particle board  
 for port dividers / panel spacers.
- 4) Location and type of input terminals optional