

MARANTZ SB REPIICA


- AS BUILT 7-29-2015

"TRIODE" MODE

LUNDHAL

LL 16C3

5K:5K

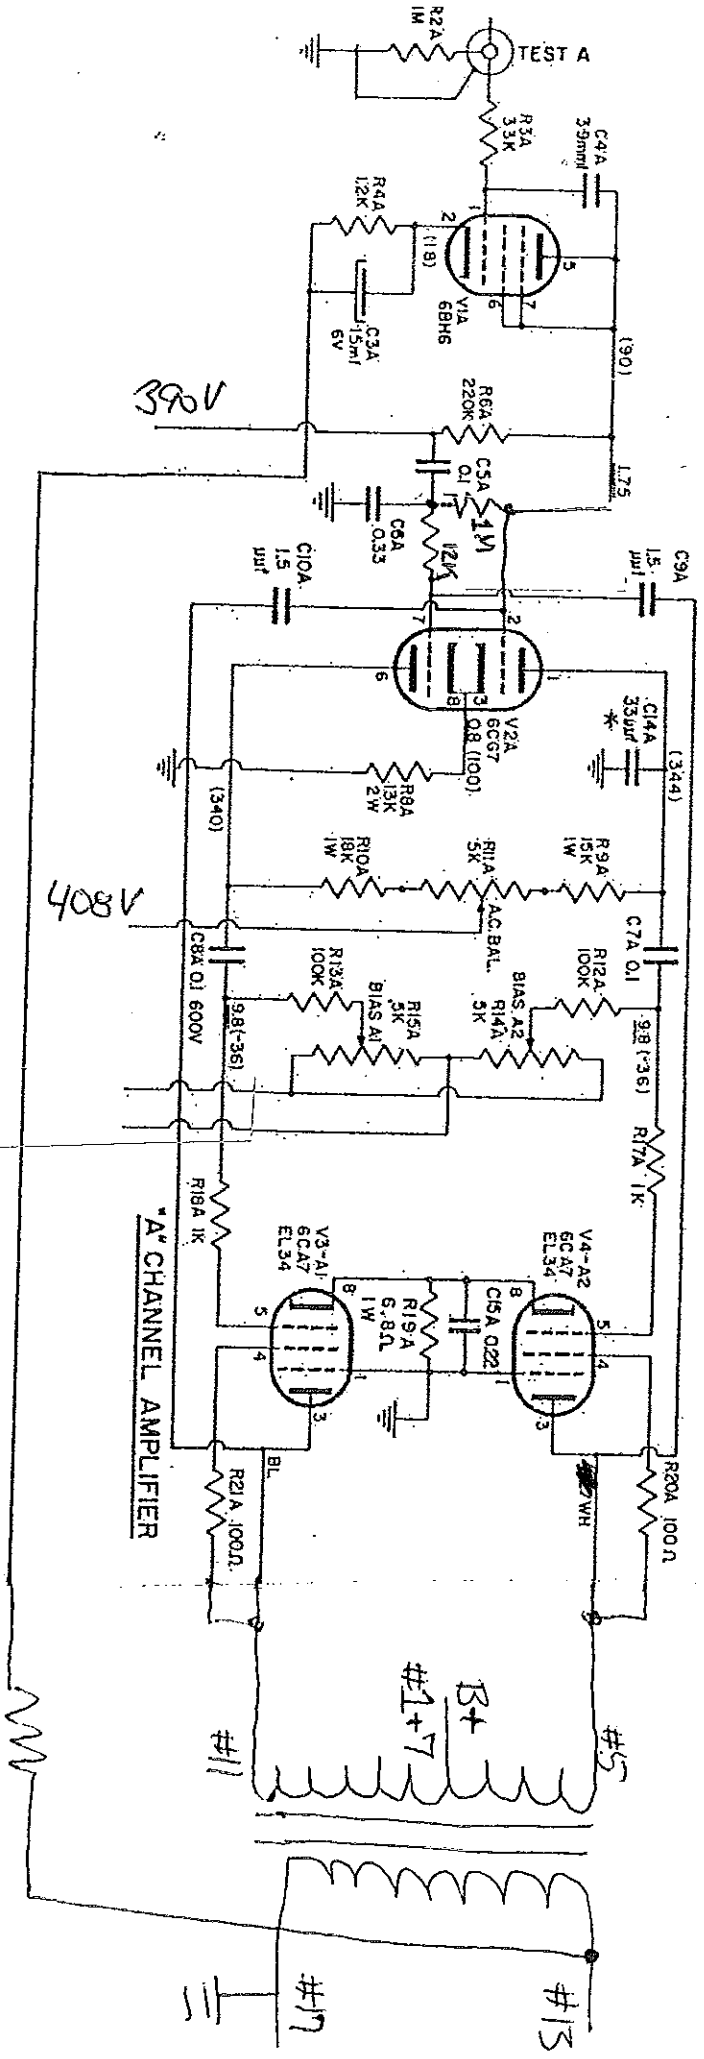

TOP = WHITE → PH 1 P.I.

BOTTOM = BLUE → PH 6 P.I.

450V B+

EL34S 446V - 385V 60mA

1.2M
-14dB

FB.