


TOP



BOTTOM

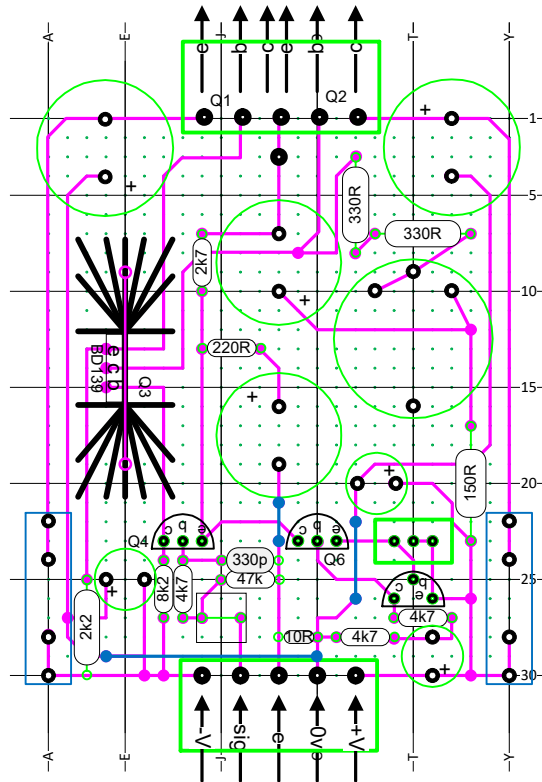