

Power


GND

Output

B

C

D

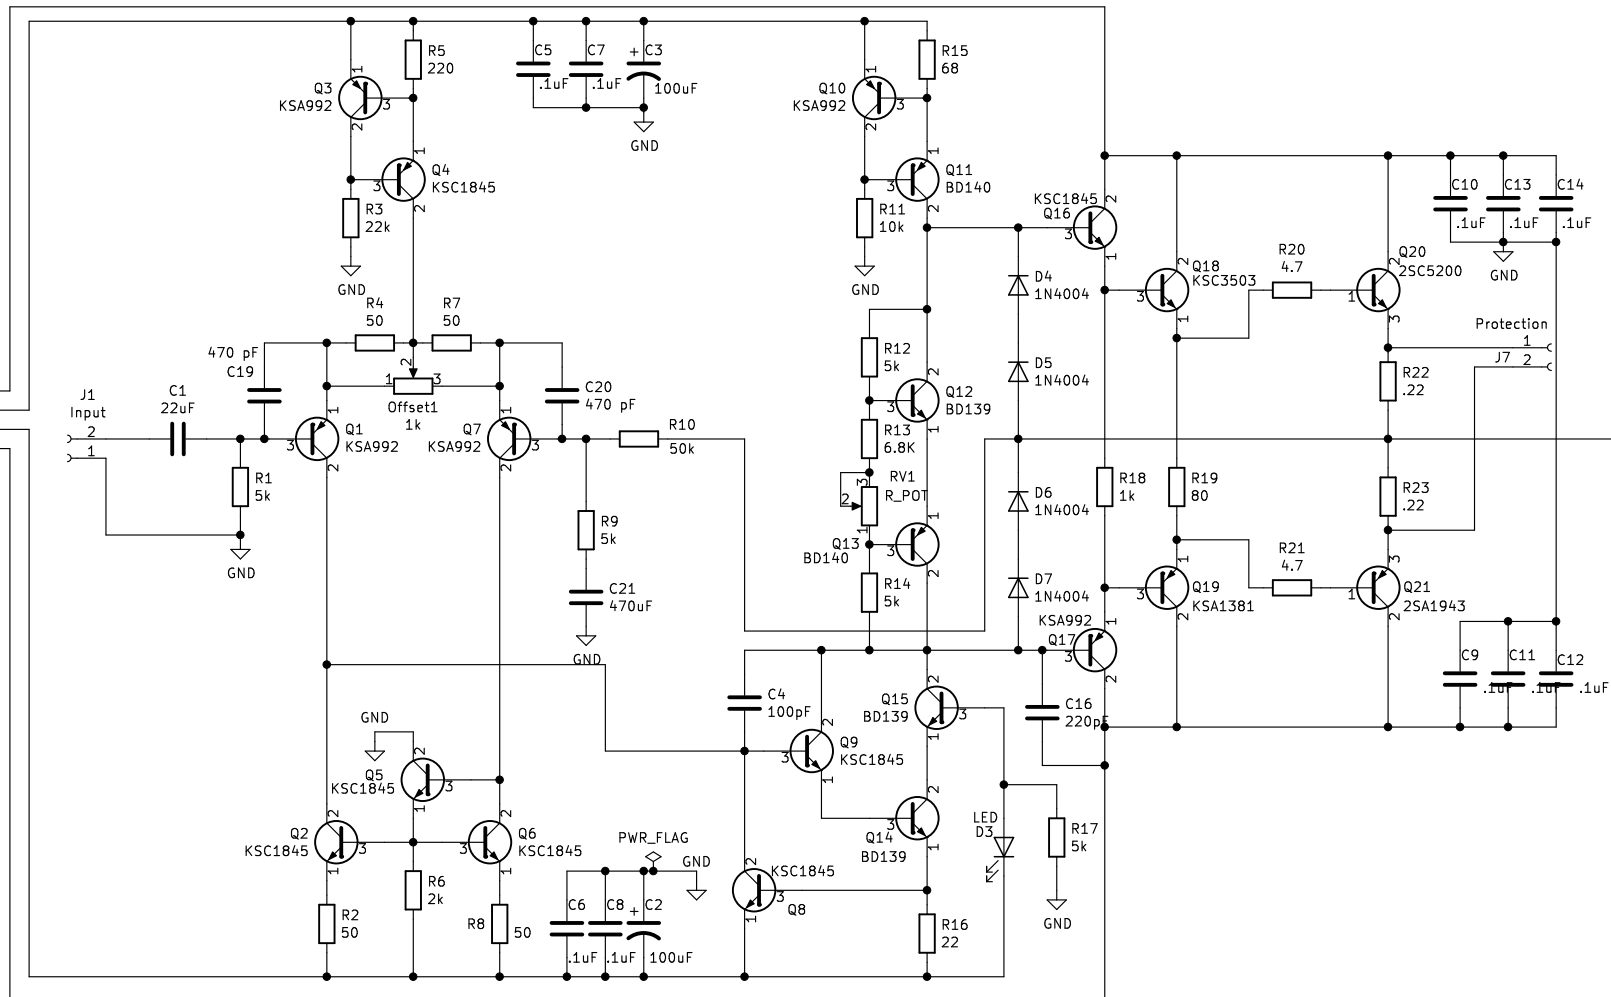

Sheet: /
File: SS Power Amp.sch

Title:

Size: A4
KiCad E.D.A. kicad (5.0.2)-1

Date:

Rev:
Id: 1/1