


Drwg based on Jky Mar. 2007  
 >> Nelson Pass, ZV5 WITH JFET INPUTS <<

>> Bobo Zen <<

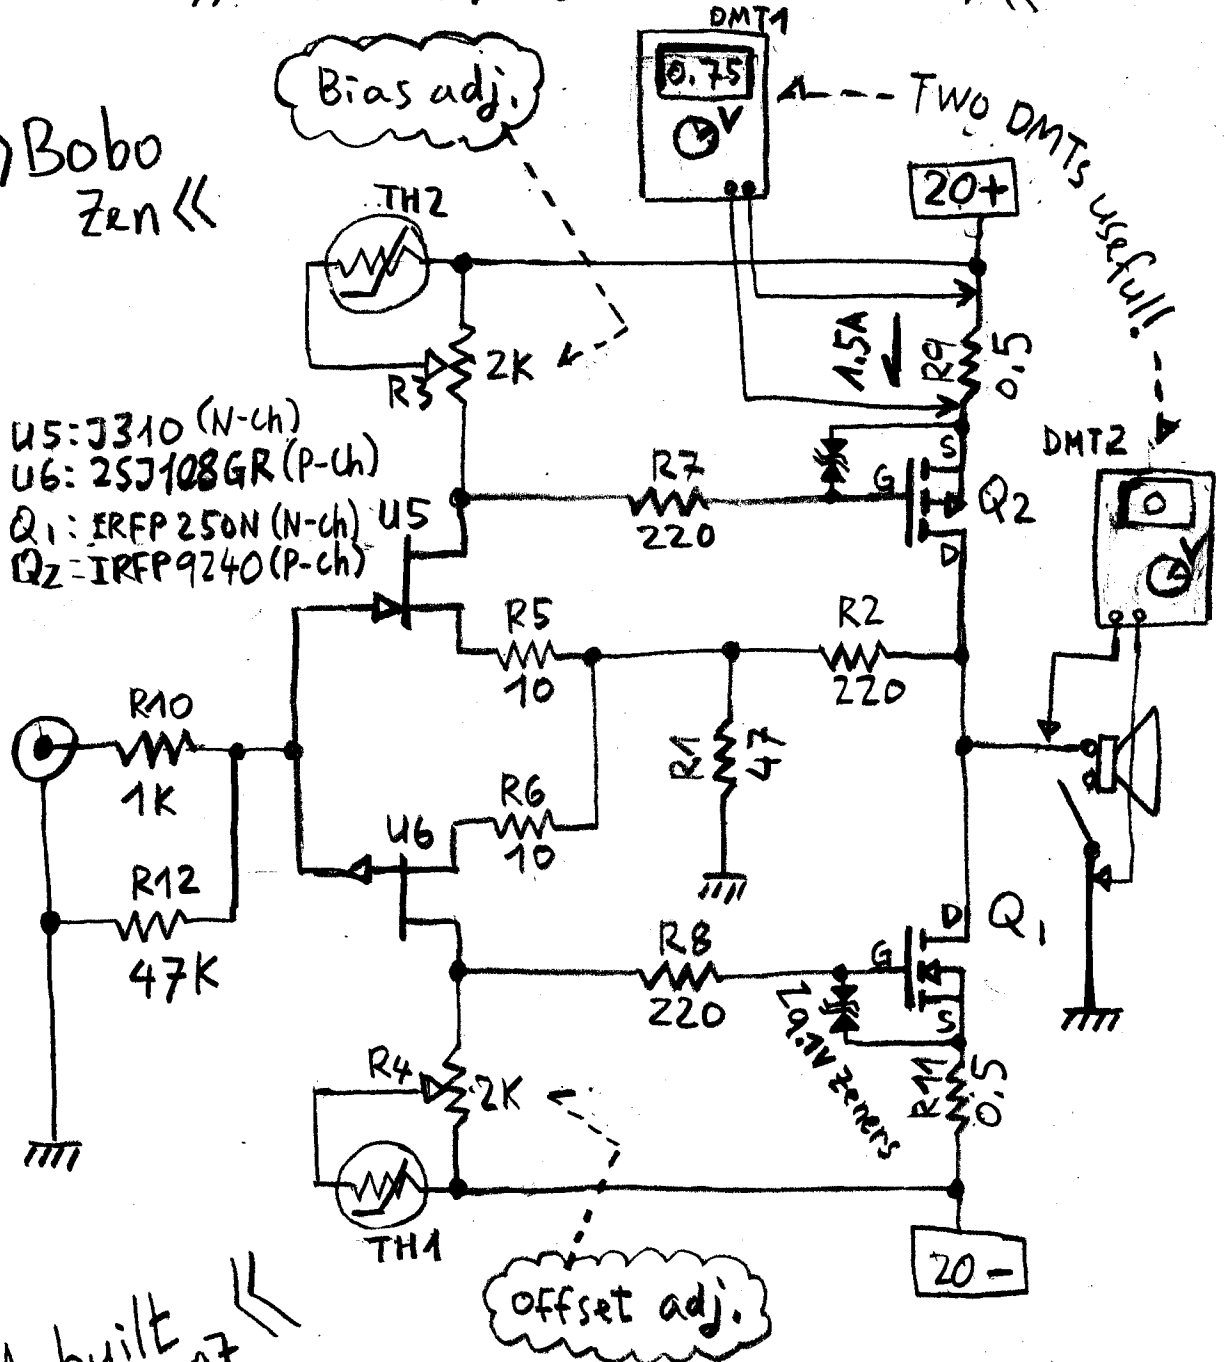

>> As built Mar. 2007 <<

Note:

- R9 & R11 Wire-wound 5W
- TH1 & TH2 10 $\Omega$ /3A thermistors
- R3 & R4 Single turn trimmer

>> Bias adjustment <<

Before soldering R9 & R11 (i.e. open), adjusted V across R3 & R4 to be about 4V and soldered R9 & R11 for final adjustment.