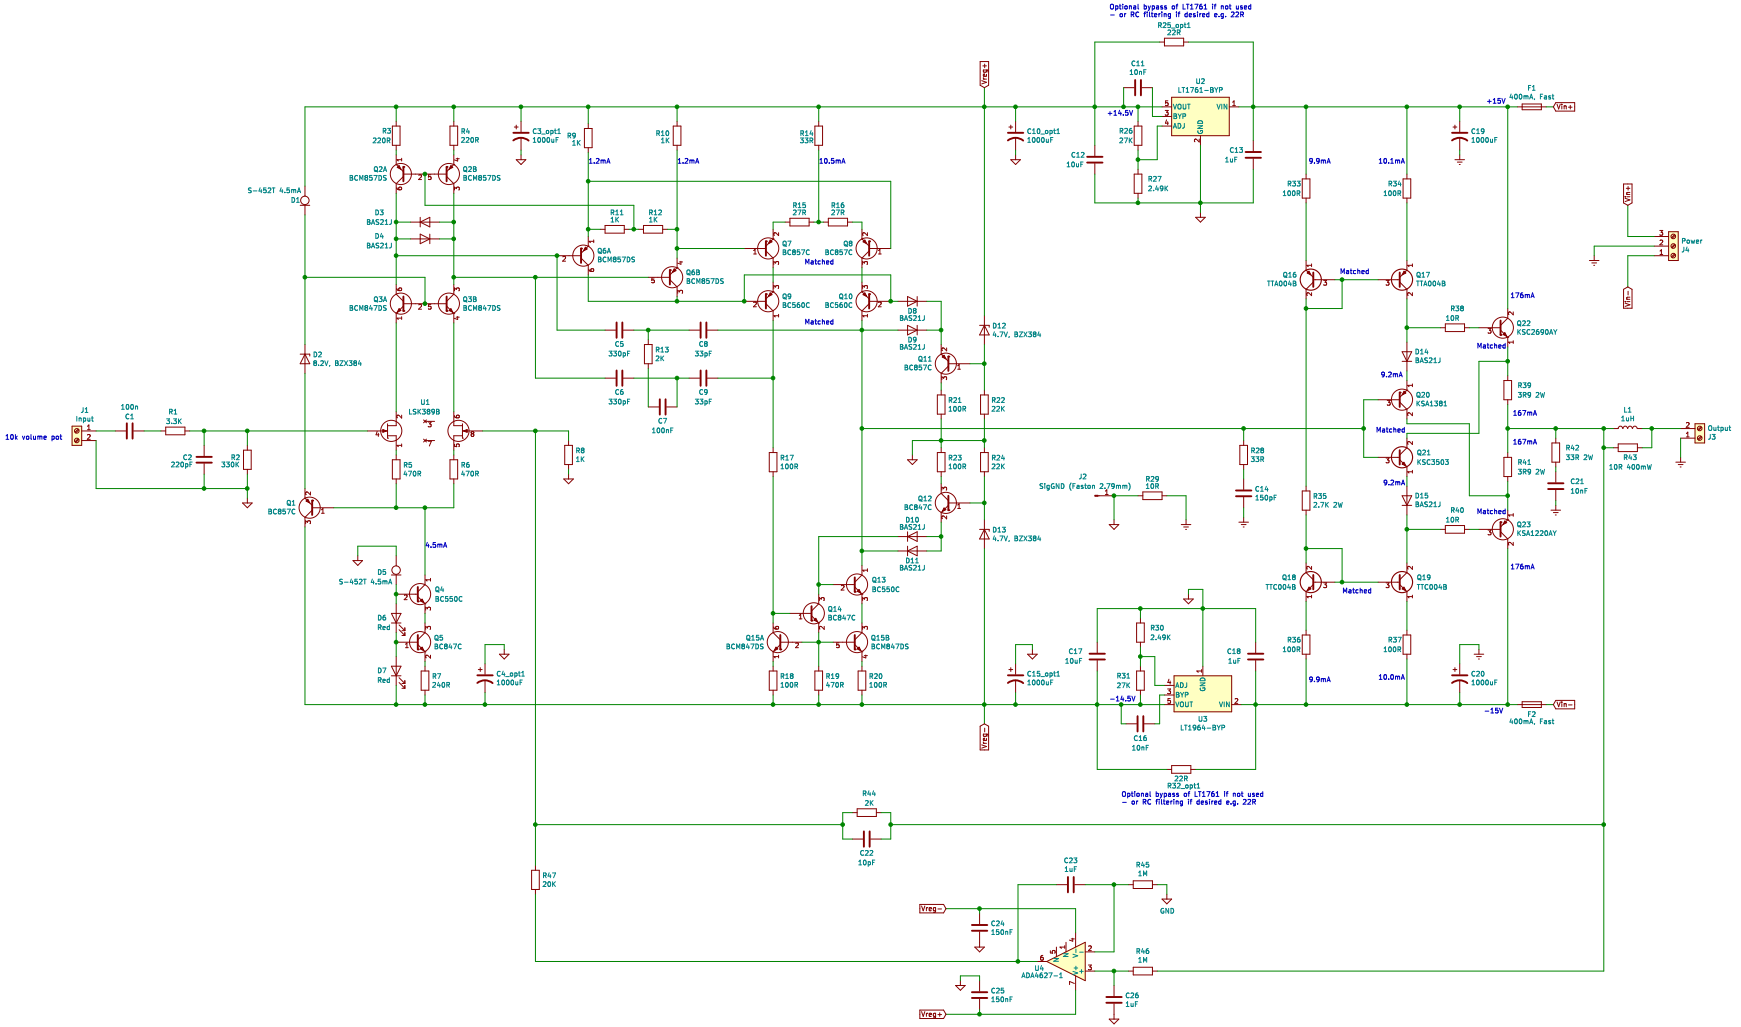

Sheets: /	
Files: schematic_as_built_26_1_22.sch	
Title:	
Size: A2	Date:
KiCad E.D.A. eeschema (5.1.4)-1	Id: 1/1